

15 Governors Court

Rutherford Business Park | Baltimore, MD 21244



Address: 15 Governors Court
Baltimore, MD 21244

Building Size: 14,582 SF

Available SF: 14,582 SF


Rental Rate: \$18.95/SF + Utilities

Parking Ratio: 5.0/1,000 SF; Free & Unreserved

Location & Amenities:

- SSA & CMMS Headquarters less than 1 mile away
- Convenient to Routes I-695, I-95, I-795, I-70, US Route 40 & I-83
- Complete range of business services available nearby including restaurants, daycare, mall and banks
- Security Cameras on site
- **Furniture may be included**

Telecom: Verizon & Comcast

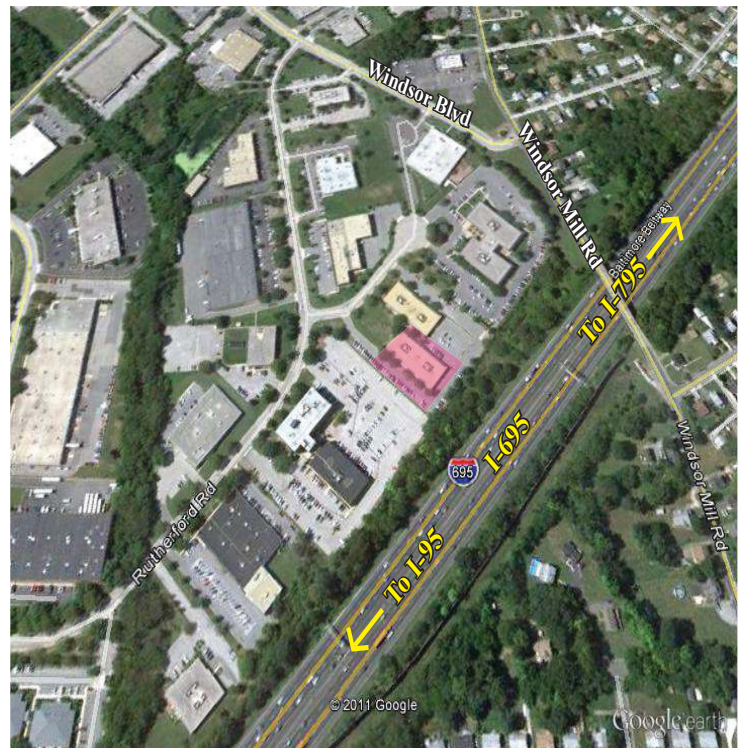

FOR MORE INFORMATION CONTACT Alan Grabush | Principal | T 443.725.9000 x114 | alang@thecsgroup.com


www.csgpartnersllc.com

15 Governors Court

Rutherford Business Park | Baltimore, MD 21244



AS-Built Floor Plan

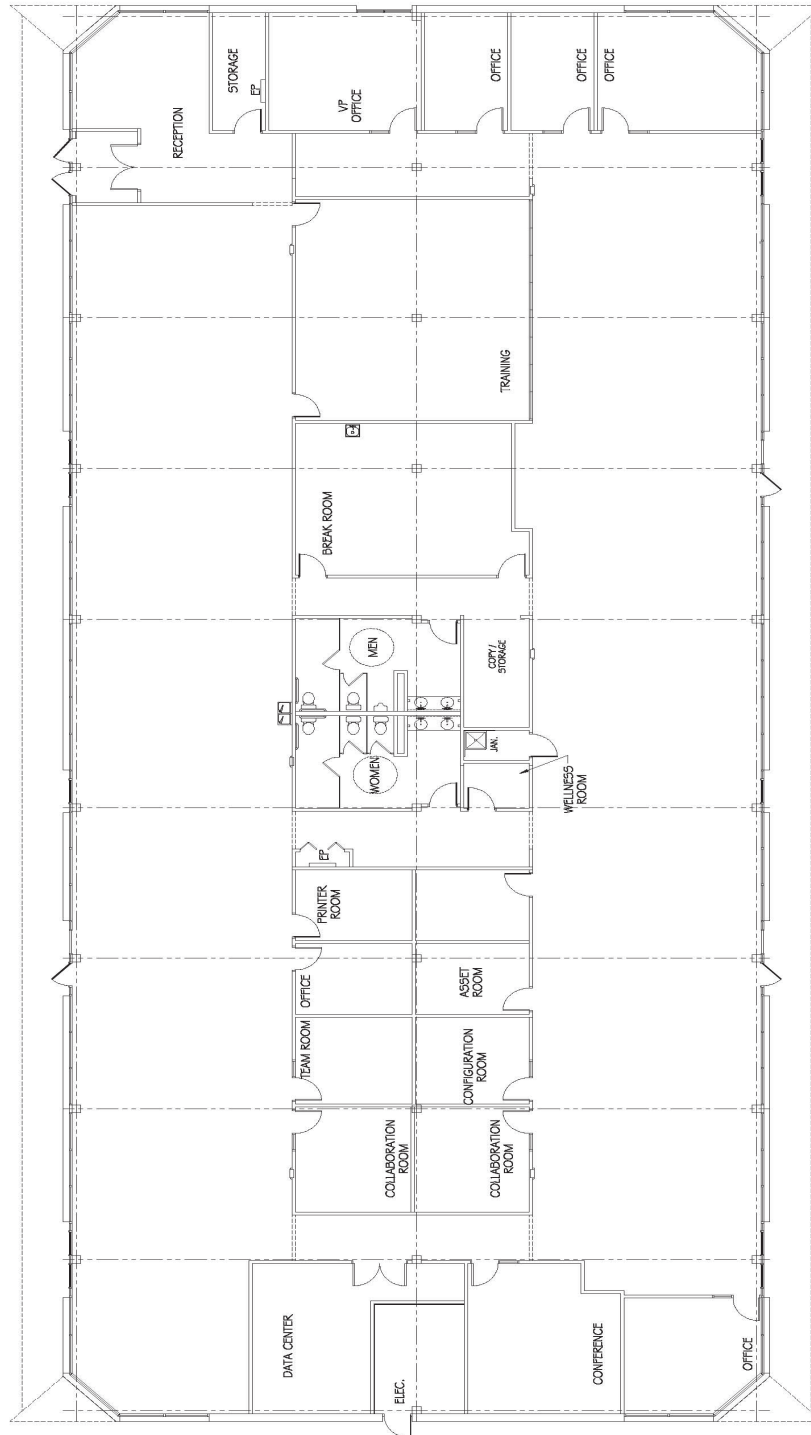

14,582 RSF

FOR MORE INFORMATION CONTACT Alan Grabush | Principal | T 443.725.9000 x114 | alang@thecsgroup.com

www.csgpartnersllc.com